APPLIED ENVIRONMENTAL TECHNOLOGIES, INC.

07/07/2000

Job#: 0693-01A Location: 2520 Temple Street, Los Angeles

Client: Sandra Sholkoff

Geologist: Lorien I. Sanders

Time Start/Finish: 10:30/12:15

Water Levels/Time/Date: 10' (10.7' upon installation)

Sheet 1 of 1 **MW-1**

Drilling Company: JET Drilling

Drilling Crew: Brad and Frank

Drilling Method: Hollow Stem Auger

Sampling Method: Split Spoon

Surface Conditions: Dirt

Depth In Feet	Sample Depth	Moisture Content	OVM (ppm)	USCS Code	DESCRIPTION
0					Dirt.
1					
2					
3					
4					
5	5.0'	moist	6	ML	CLAYEY SILT (ML), dark brown, medium stiff to stiff (5/6/13), moist.
6	(10:37)				
7					
8					
9					
10	10.0'	moist	178		Olive grayish-brown, stiff to very stiff (10/20/25, mild petroleum hydrocarbon odor.
11	(10:45)				Downhole hammer wet.
12					
13					
14					Color change to yellowish orange-brown at 14.5'.
15	15.0'	moist	5	CL	CLAY (CL), yellowish orange-brown, stiff to very stiff (8/13/21).
16	(10:55)				
17					
18					
19					
20	20.0'	No	Recovery		No recovery. Stiff (9/14/16).
21	(11:05)				
22					
23					
24					
25	25.0'	saturated	0		SANDY SILTY CLAY, yellowish orange-brown, medium stiff to very stiff (6/14/17), sand very fine grained, caliche, poorly graded.
26					
27					Boring terminated at 25.0'.
28					
29					
30					
31					
32					
33					
34					
35					
36					
37					
38					
39					
40					

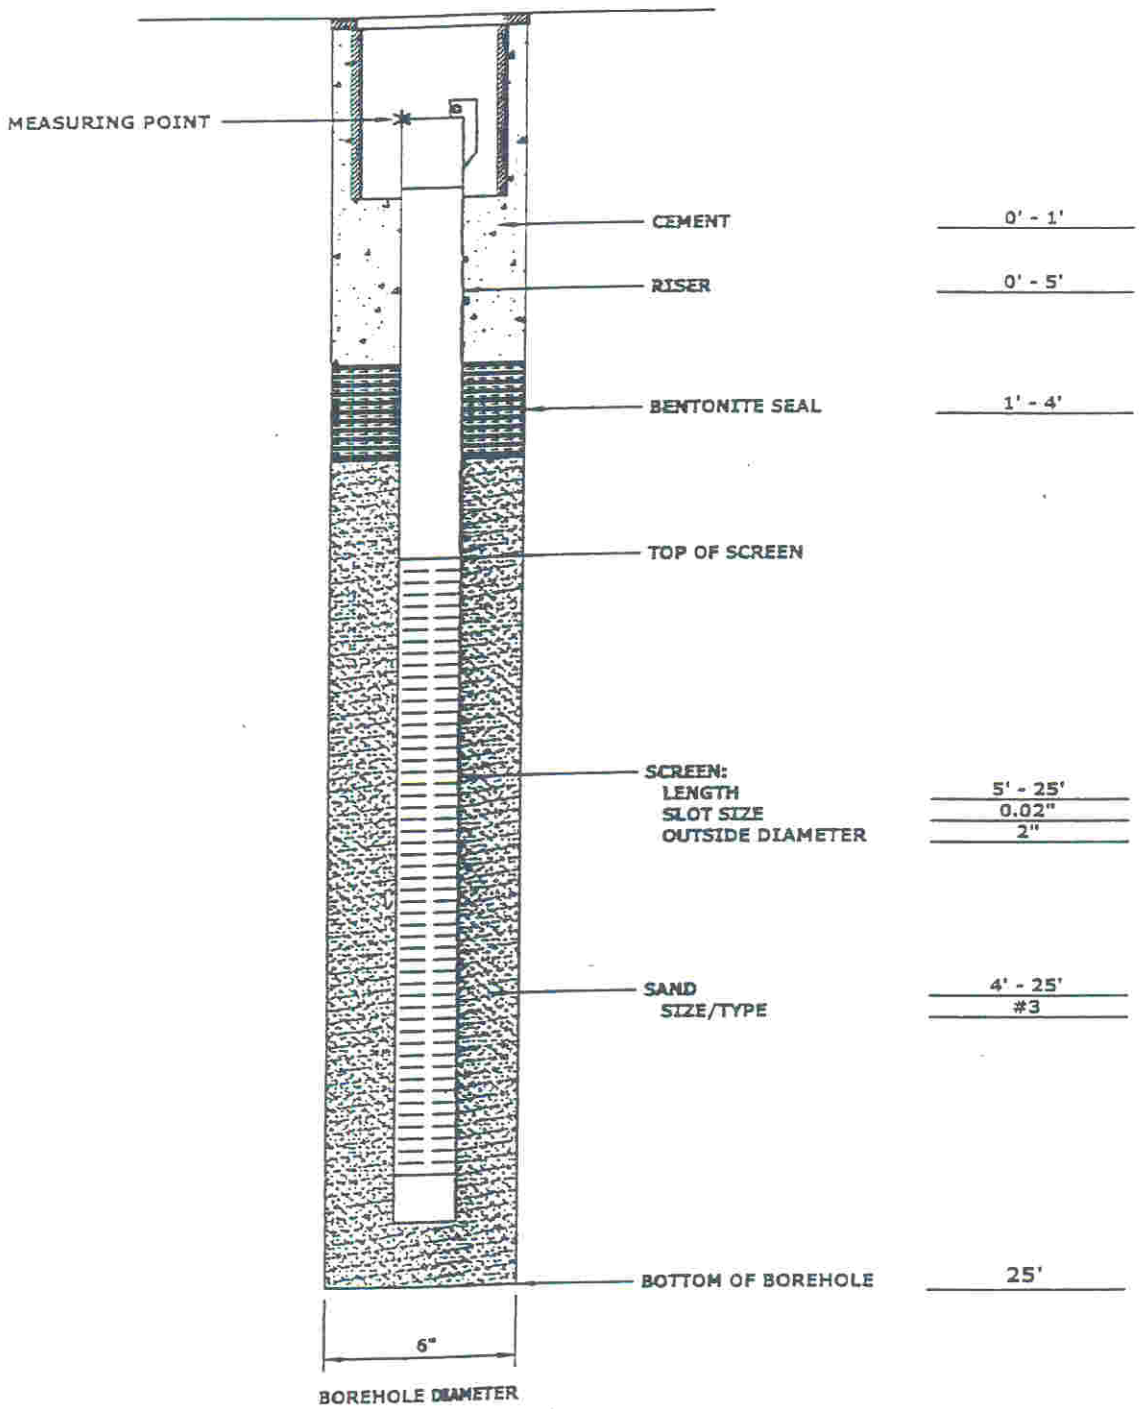

Applied Environmental Technologies, Inc.
4840 Market Street, Suite B • Ventura, California 93003
Phone (805)650-1400 Fax (805)650-1576

GROUNDWATER MONITORING WELL MW-1
AS BUILT DIAGRAM
2520 TEMPLE STREET
LOS ANGELES, CALIFORNIA

PLATE REFERENCE 069301A1A	PROJECT NUMBER 0693-01A	SEPTEMBER 14, 2000