APPLIED ENVIRONMENTAL TECHNOLOGIES, INC.

07/06/2000

Sheet 1 of 1 **MW-4**

Job: 0693-01A Location: 2520 Temple Street, Los Angeles

Drilling Company: JET Drilling

Client: Sandra Sholkoff

Drilling Crew: Brad and Frank

Geologist: Lorien I. Sanders

Drilling Method: Hollow Stem Auger

Time Start/Finish: 08:15/10:00

Sampling Method: Split Spoon (2" Brass Liners)

Water Levels/Time/Date: 10' (12.82' on 7/7/00 before well develop)

Surface Conditions: Asphalt

Depth In Feet	Sample Depth	Moisture Content	OVM ppm	USCS Code	DESCRIPTION
0				------	Asphalt. Moderate petroleum hydrocarbon odors immediately below asphalt, soil dark
1					grayish-brown.
2					
3					
4				ML	
5	5.0'	dry to	23		SILT (ML), medium gray, medium stiff (5/8/7), few fine grained sand, moderate petroleum
6	(08:25)	damp			hydrocarbon odor.
7					Ambient air 5' perimeter from hole up to 11 ppm.
8					
9					
10	10.0'	dry to	359		CLAY/SILT (CL/ML), light gray, stiff (8/13/14), thin layer of wet silt above bedrock.
11	(08:35)	damp		CL/ML	
12					Strong petroleum hydrocarbon odor.
13					
14					
15	15.0'	dry to	236		Very stiff (13/15/29).
16	(08:45)	damp			
17					
18					
19					Groundwater ~10', sampled at 15.0', straight drill to 25.0', set well.
20					
21					
22					
23					Cuttings medium brown.
24					
25	25.0'				Boring terminated at 25.0'.
26					
27					
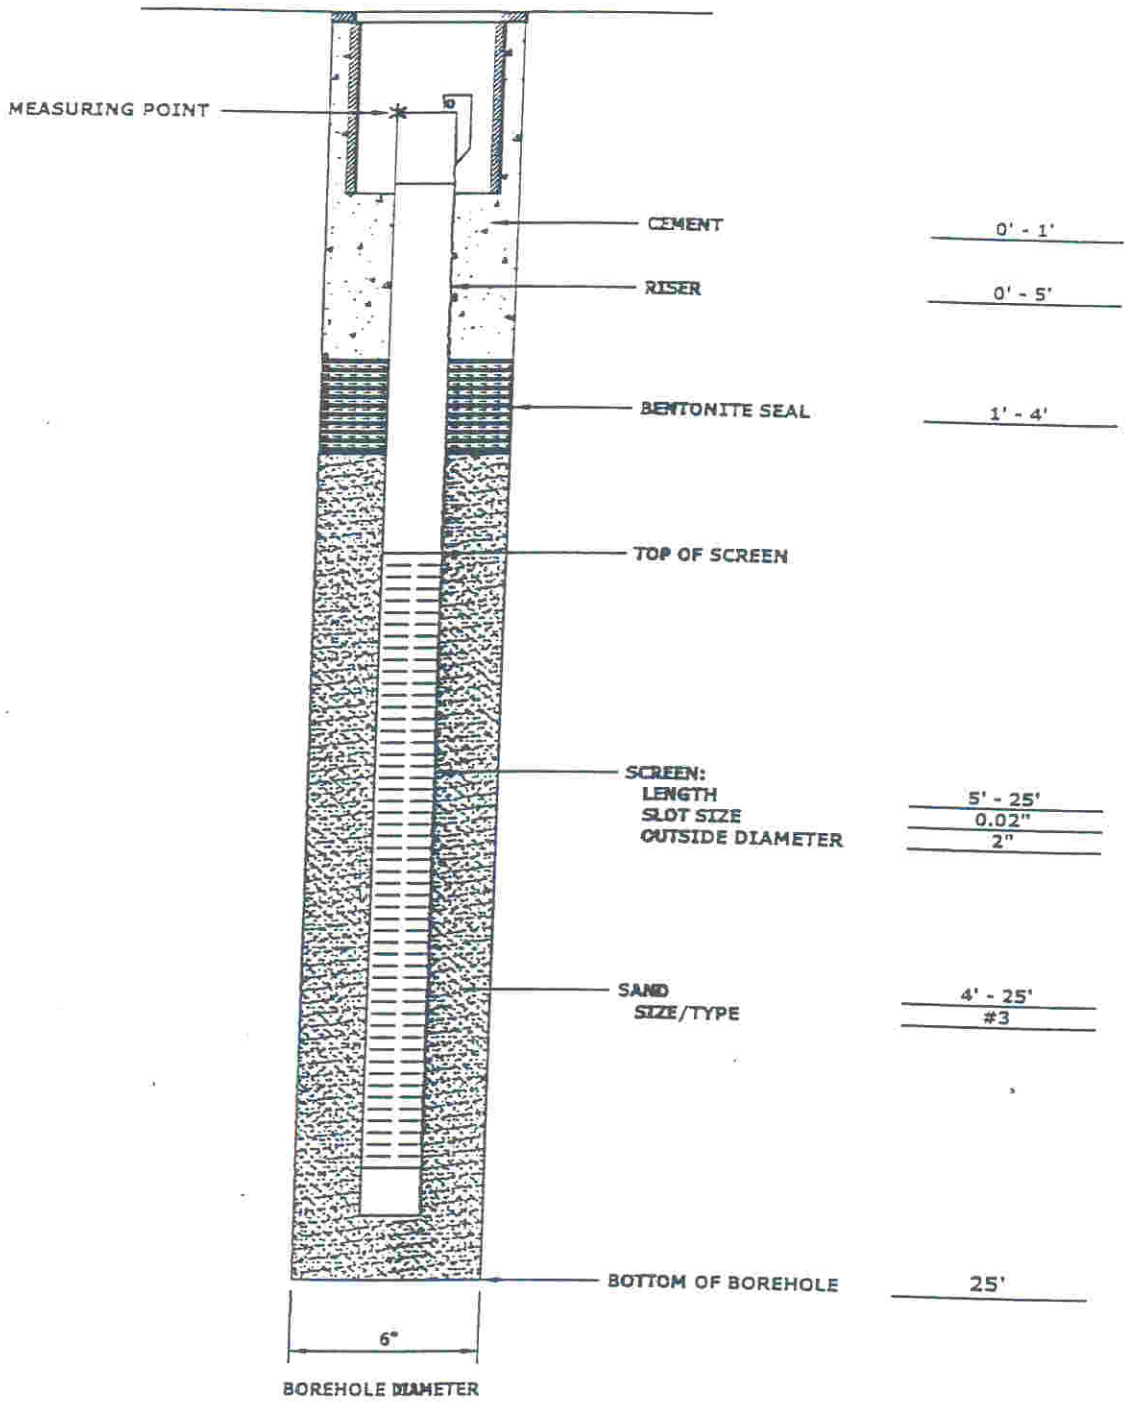

Applied Environmental Technologies, Inc.
4840 Market Street, Suite B • Ventura, California 93003
Phone (805)650-1400 Fax (805)650-1576

GROUNDWATER MONITORING WELL MW-4
AS BUILT DIAGRAM
2520 TEMPLE STREET
LOS ANGELES, CALIFORNIA

PLATE REFERENCE 069301A18	PROJECT NUMBER 0693-01A	SEPTEMBER 14, 2000